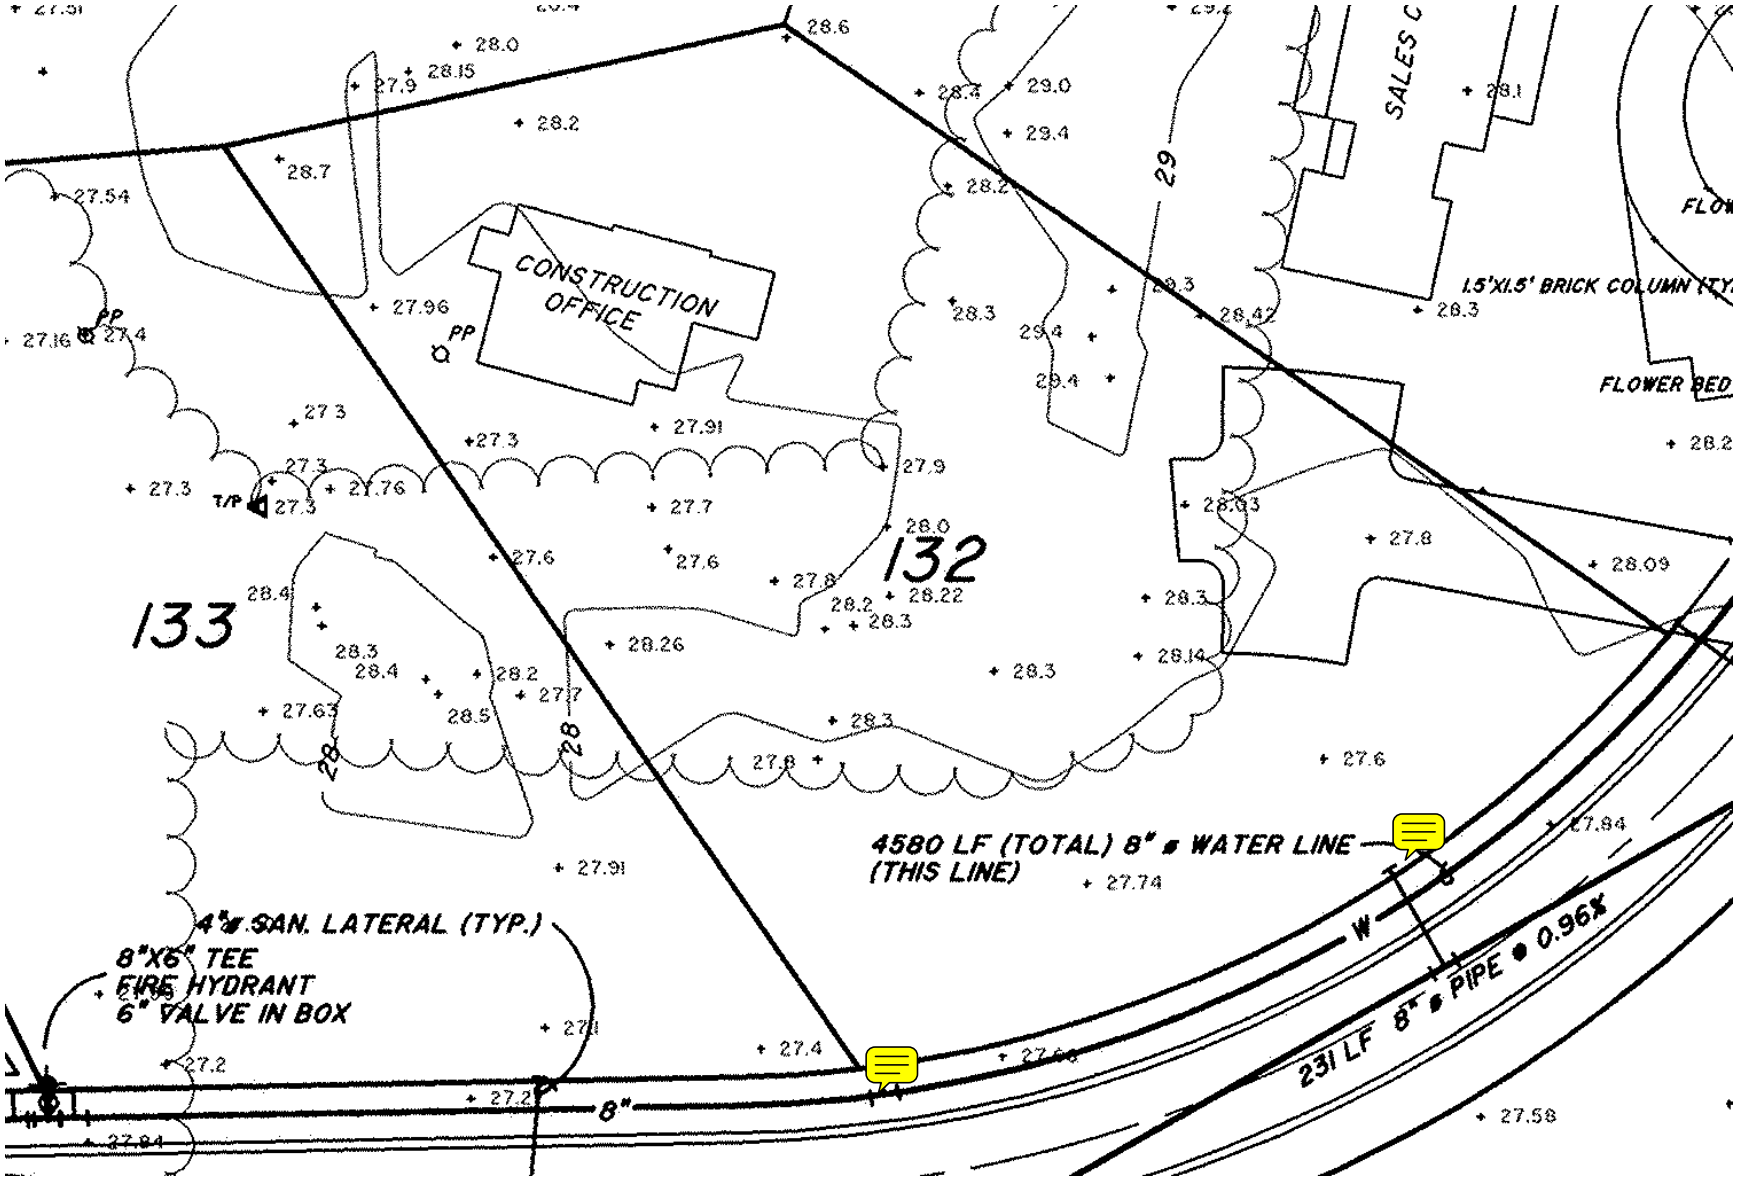
CONSTRUCTION OFFICE
SALES C
1.5'X1.5' BRICK COLUMN (TY.
FLOWER BED
133
132
4580 LF (TOTAL) 8" ø WATER LINE
(THIS LINE)
4"ø SAN. LATERAL (TYP.)
8"X6" TEE
FIRE HYDRANT
6" VALVE IN BOX
231 LF 8" ø PIPE @ 0.96%
8"
W
PP
T/P